

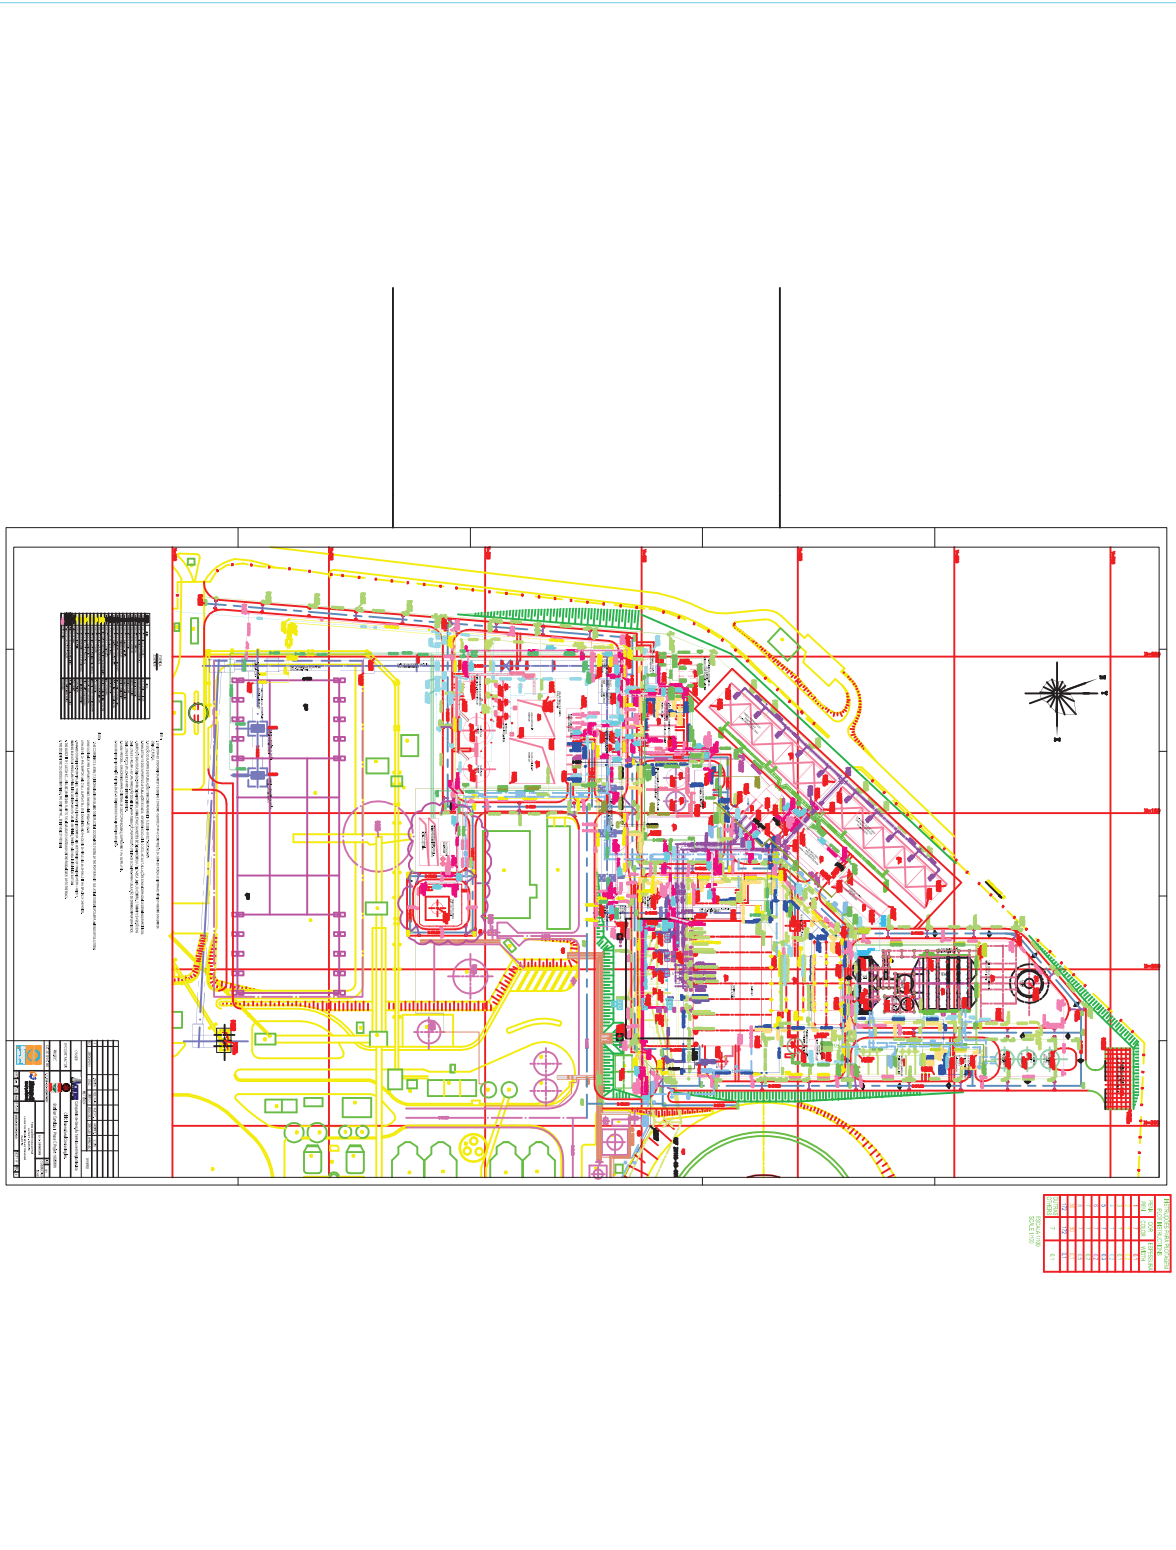


ANEXO V

PLANTAS DE DRENAGEM

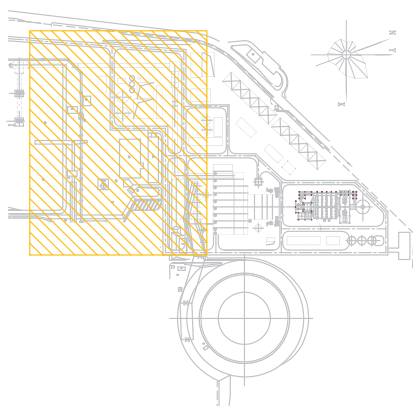

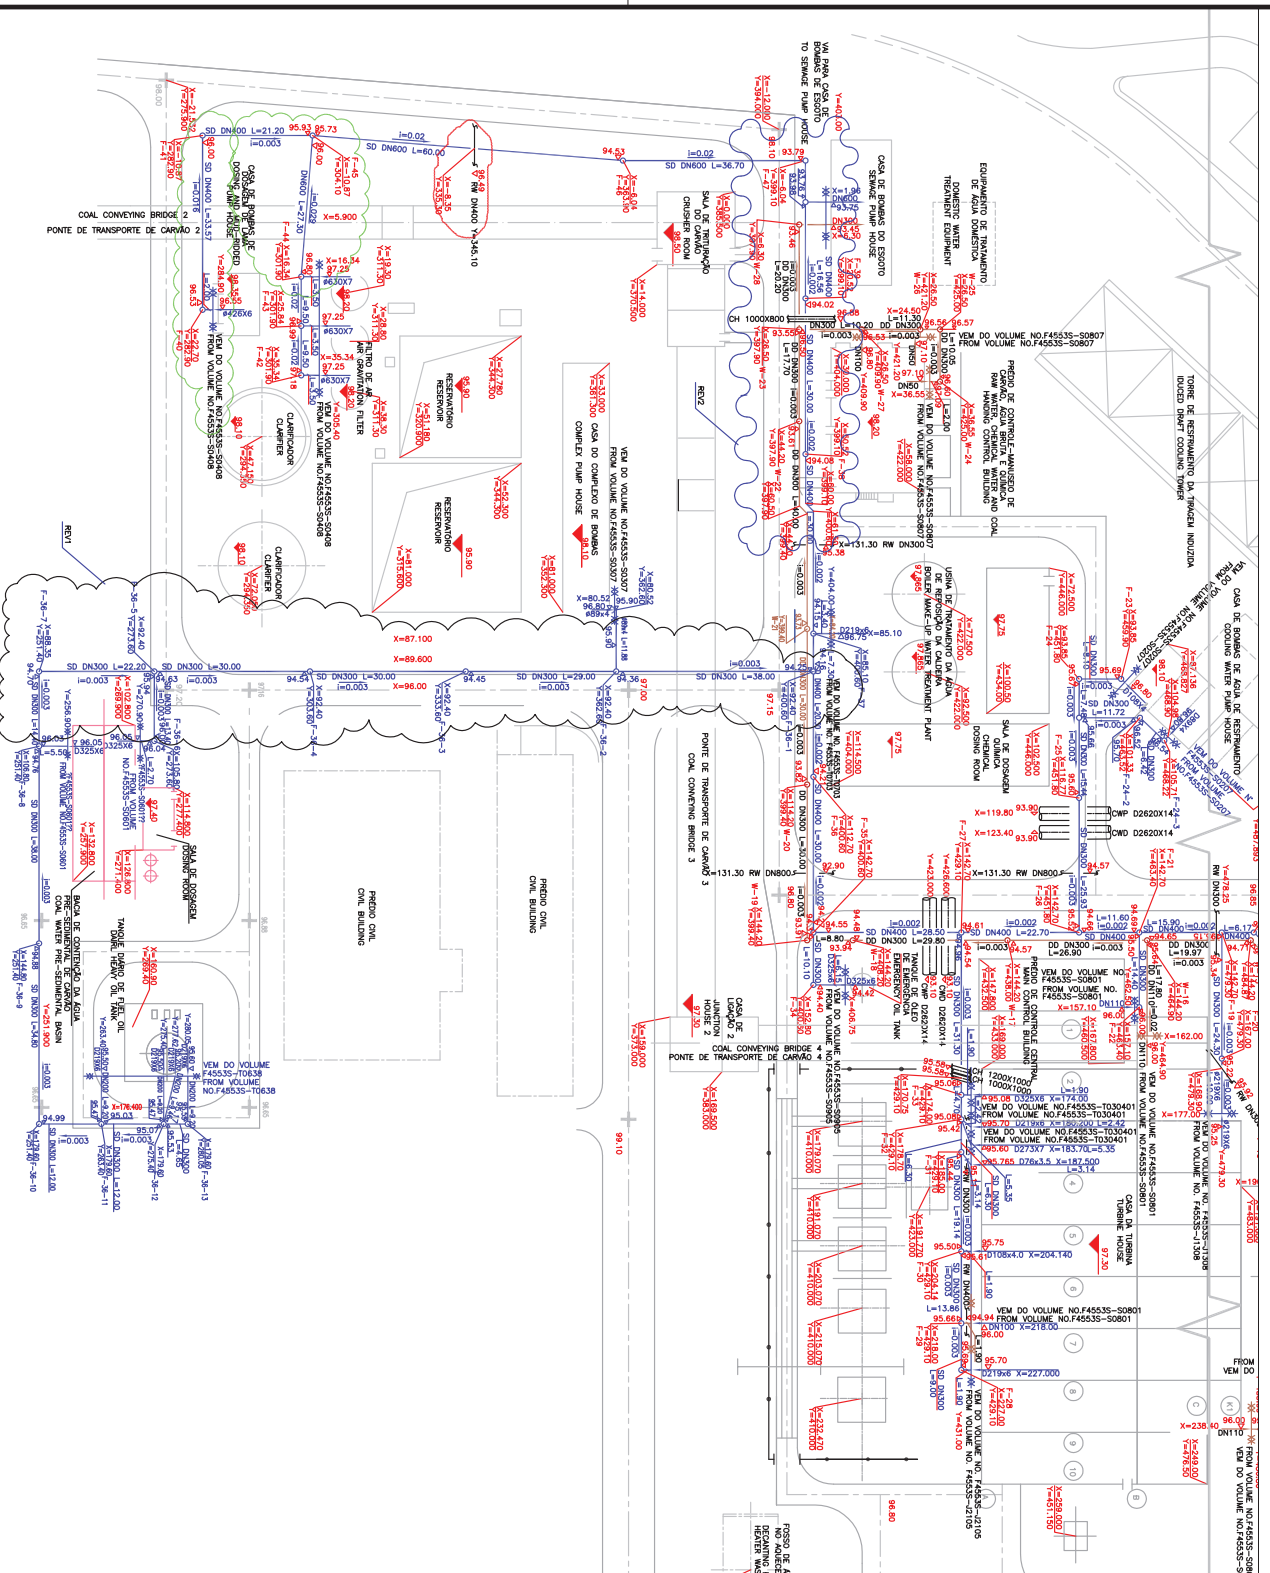

OWNER	CGTE Companhia de Gestão Técnica de Energia Elétrica	
ERC CONTRACTOR	CITIC Intermodal Contracting Inc.	
PROJECT	Phase 3 - Bredão Candonga II Phase C Project 1X350MW	
CDTEL DWG NO	12453S-COM-002	
DATE	18/05/2008	
SCALE	1:1	
DATE	18/05/2008	
STATUS	AS-BUILT	
DESIGNER	Mweddi	
CHECKER	Senger	
DATE	18/05/2008	
STATUS	AS-BUILT	
DESIGNER	Mweddi	
CHECKER	Senger	
DATE	18/05/2008	
STATUS	AS-BUILT	

