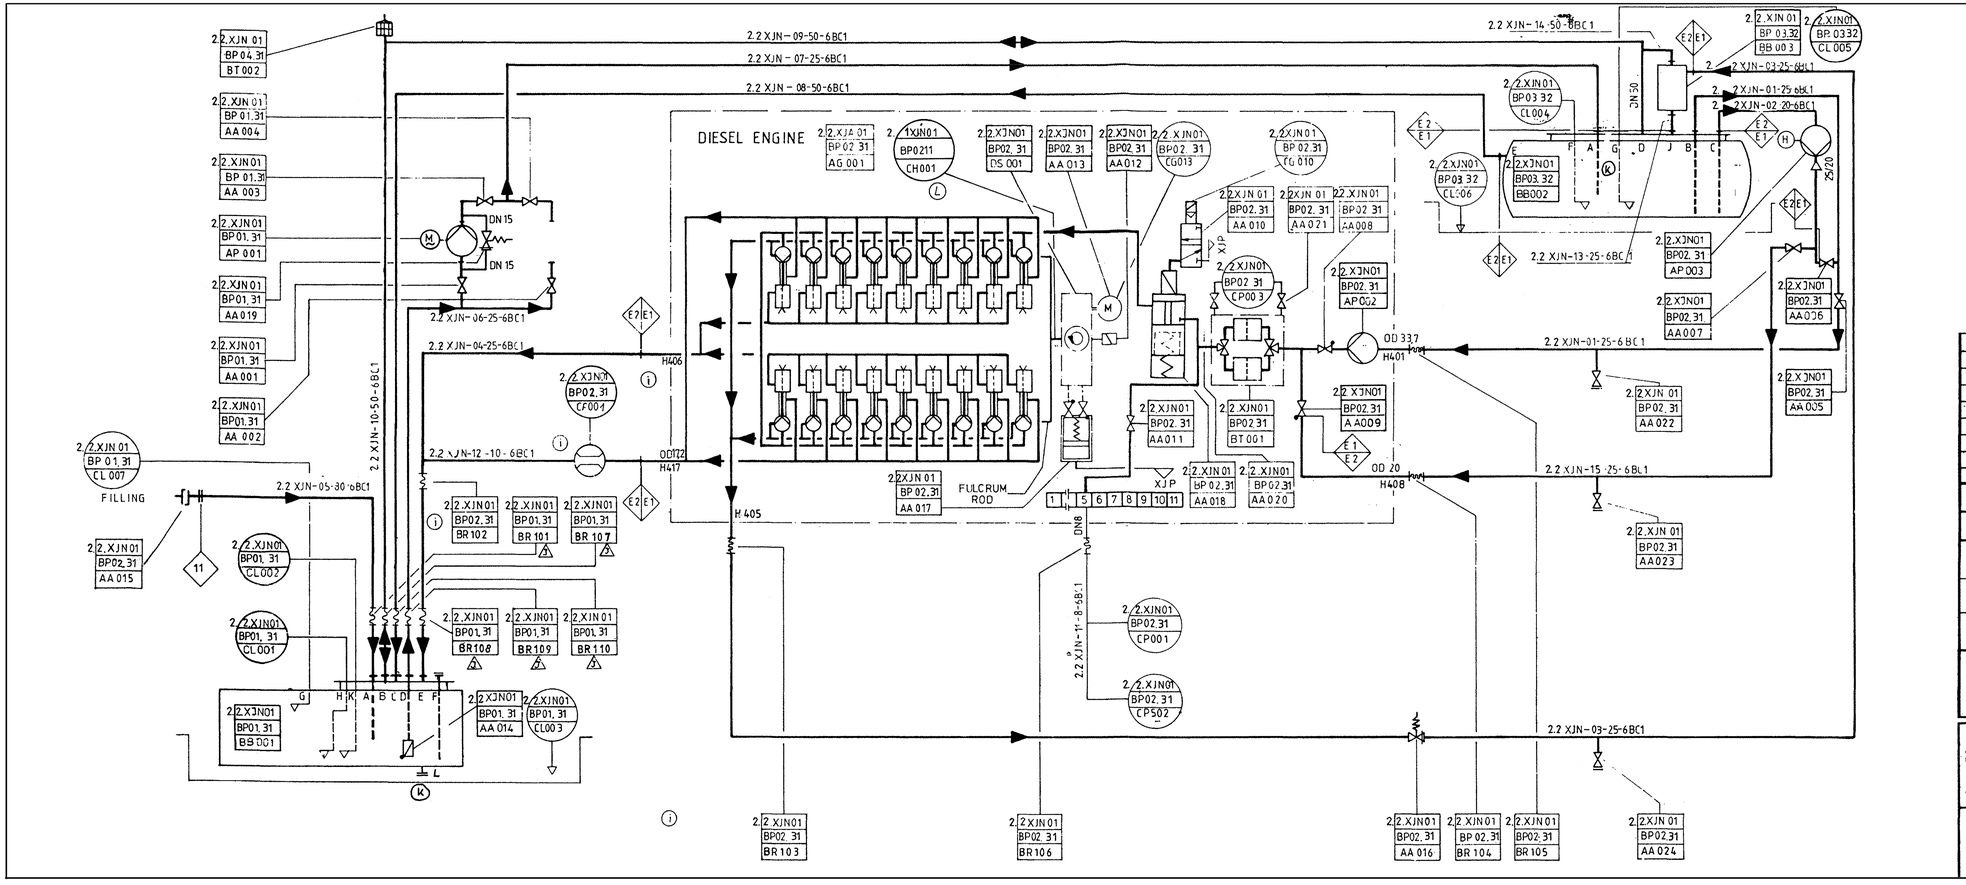

XJP = DIESEL COMPRESSED AIR SYSTEM

OD = OUTSIDE DIAMETER

PIPELINE NUMBER

2 XJN - 14 - 50 - 6BC1

- PIPING CLASS
- DIAMETER NOMINAL (SIZE)
- RUNNING NO.:
- FLUID
- REDUNDANCE

Export classification AL: N ECCN: N
Goods labelled with „AL not equal to N" are subject to European or German export authorization when being exported out of the EU. Goods labelled with „ECCN not equal to N" are subject to US export authorization when being exported out of the EU. Even if no export authorization is required due to the final whereabouts and purpose for which the goods are to be used.

Rev.	Art der Änderung / Description of Revisions	Datum / Date	Gez. / Made	Gepr. / Ch'd	Freigeg. / App'd
m	as built com.	20.7.00	Bab	[illegible]	[illegible]
L	XJN01 CH001 new	04.7.99	Bab	gez. Stapel	[illegible]
K	Revised	7.2.92	Babacan	Görzig	[illegible]
j	REVISED KWU-No. AND △	10.7.84	Lehmann	Ulsperger	[illegible]
i	REVISED, COMPL. AND DRWG.NO.: 740 03170 G CHANGED	27.04.83	ULSP.	[illegible]	
h	REVISED AND DRWG.NO.: 4E 19K 3596E CHANGED	15.03.82	Wirling, F	[illegible]	

ANDERUNGEN REVISIONS

XG/ 2.2 XJN 01/001

KWU ANGRA II, BUILDING UBP (D1)

15.03.82 Wirling, F
03.05.83

KHD Engineering GmbH

FUEL OIL DIAGRAM
DIESELKRAFTSTOFF SCHEMA

4E 19K 3596E/2.2
BL 1

U2000304

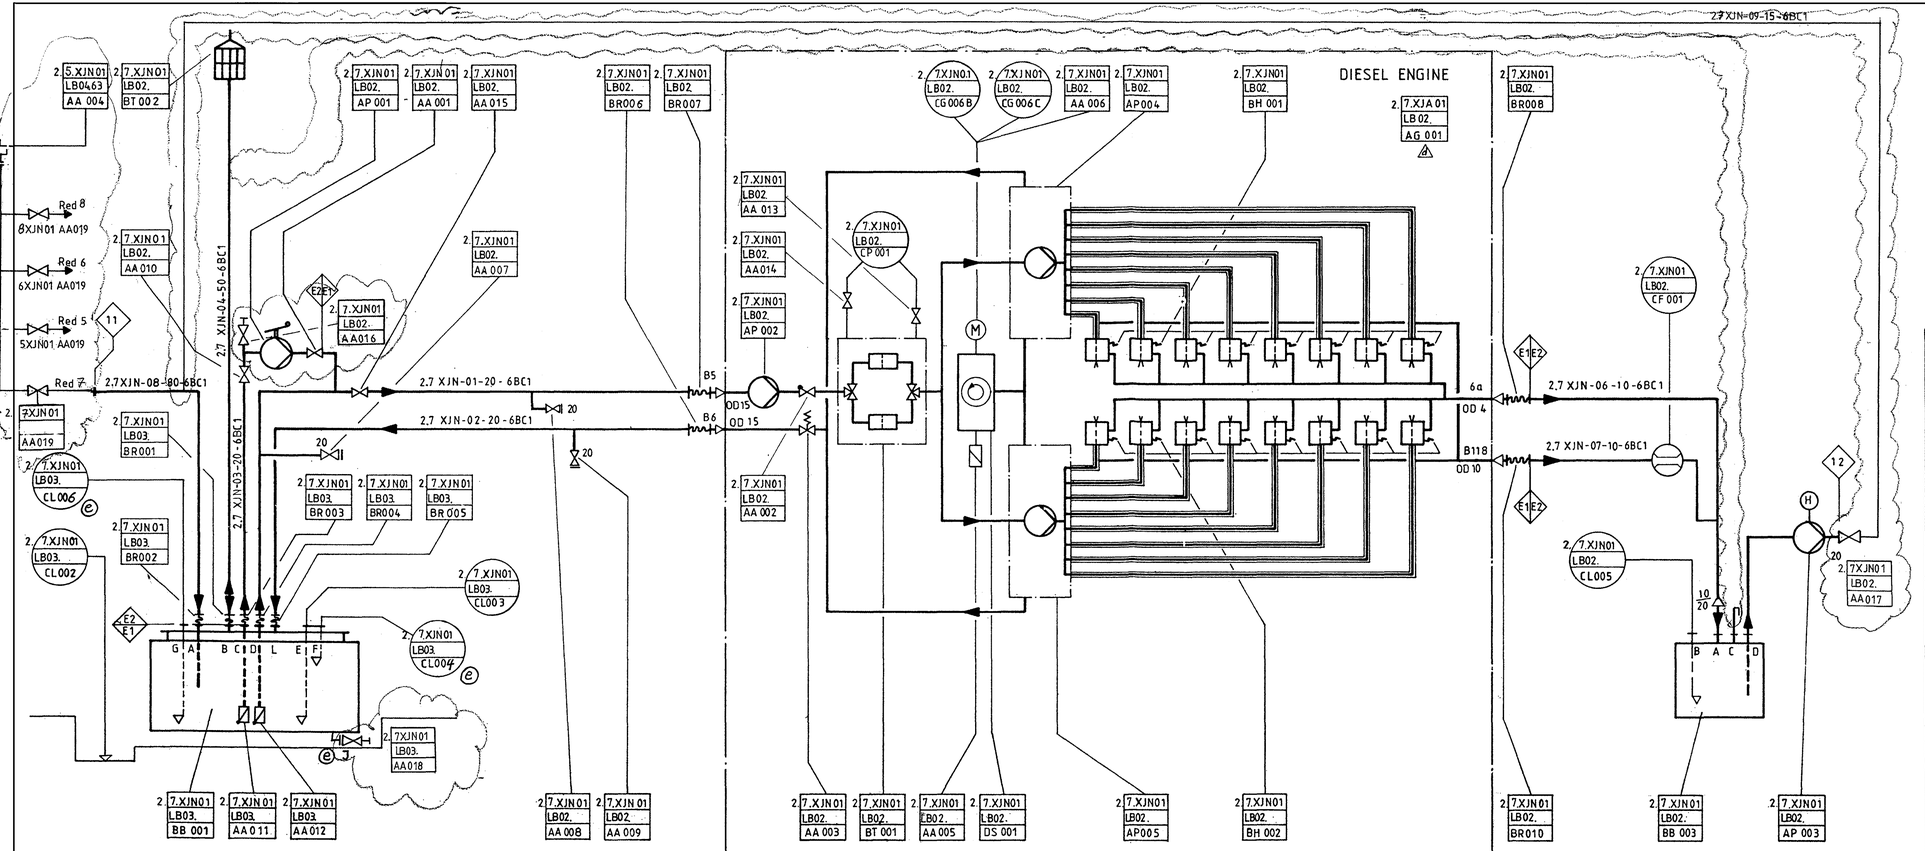

OD = OUTSIDE DIAMETER

PIPELINE NUMBER

2.7 XJN-02-40-6BC1

- PIPING CLASS
- DIAMETER NOMINAL (SIZE)
- RUNNING NO.:
- FLUID
- REDUNDANCY

Export classification: AL = not subject to export licence (ECCN) or export authorization when being exported out of the EU (Dual-Use-Regulation). ECCN not known at this stage. Export authorization may be required, e.g. for projects with participation of companies from the USA. In case of doubt, please contact us before the goods are to be used.

Rev.	Art der Änderung Description of Revisions	Datum Date	Gez. Made	Gepr. Ch'd	Freigeg. App.'d
f	as built com.	04.07.00	Esta	Knolle	
e	Revised (e)	30.10.92	Babacan	Görzig	
d	REVISED KWU - NR AND (A)	10.2.84	Hinke	Ulsperger	
c	DRAWING COMPLETED AND REVISED	3.1.84	Hanke		
b	COMPLETED	2306.83	ULSPERGER		
a	REVISED AND DRWG.NO.: 4E19K 3708E CHANGED	30.04.82	Wirling, J	Lisken	

ÄNDERUNGEN REVISIONS

XG/ 2.7 XJN 01/001

FURNAS

Kunde und Kennwort Client and Code Word:

KWU ANGRA II, BUILDING ULB (D2)

	Datum Date	Name Name
Gezeichnet: Made:	30.04.82	Wirling, J
Geprüft: Checked:		Lisken
Freigeg.: Approved:	11.6.83	Knoll
Maßstab Scale	1:/	

KHD Engineering GmbH

FUEL OIL DIAGRAM
DIESELKRAFTSTOFF SCHEMA

Zeichnungs Nr. Drawing No.: 740 03360-G/2.7

U2000309