LEGEND	
	BOTTOM MUD GUNS
	SUCTION STRAINER
	SUCTION DAMPENER
P	PRESSURE INDICATOR
	SUCTION VALVE
	REDUCER
	BUTTERFLY VALVE
B	BALL VALVE
P	POP OFF VALVE
	GATE VALVE
	RELIEF VALVE
	DUMP VALVE
	FLEX JOINT
	WASH DOWN REEL
	PULSATION DAMPENER

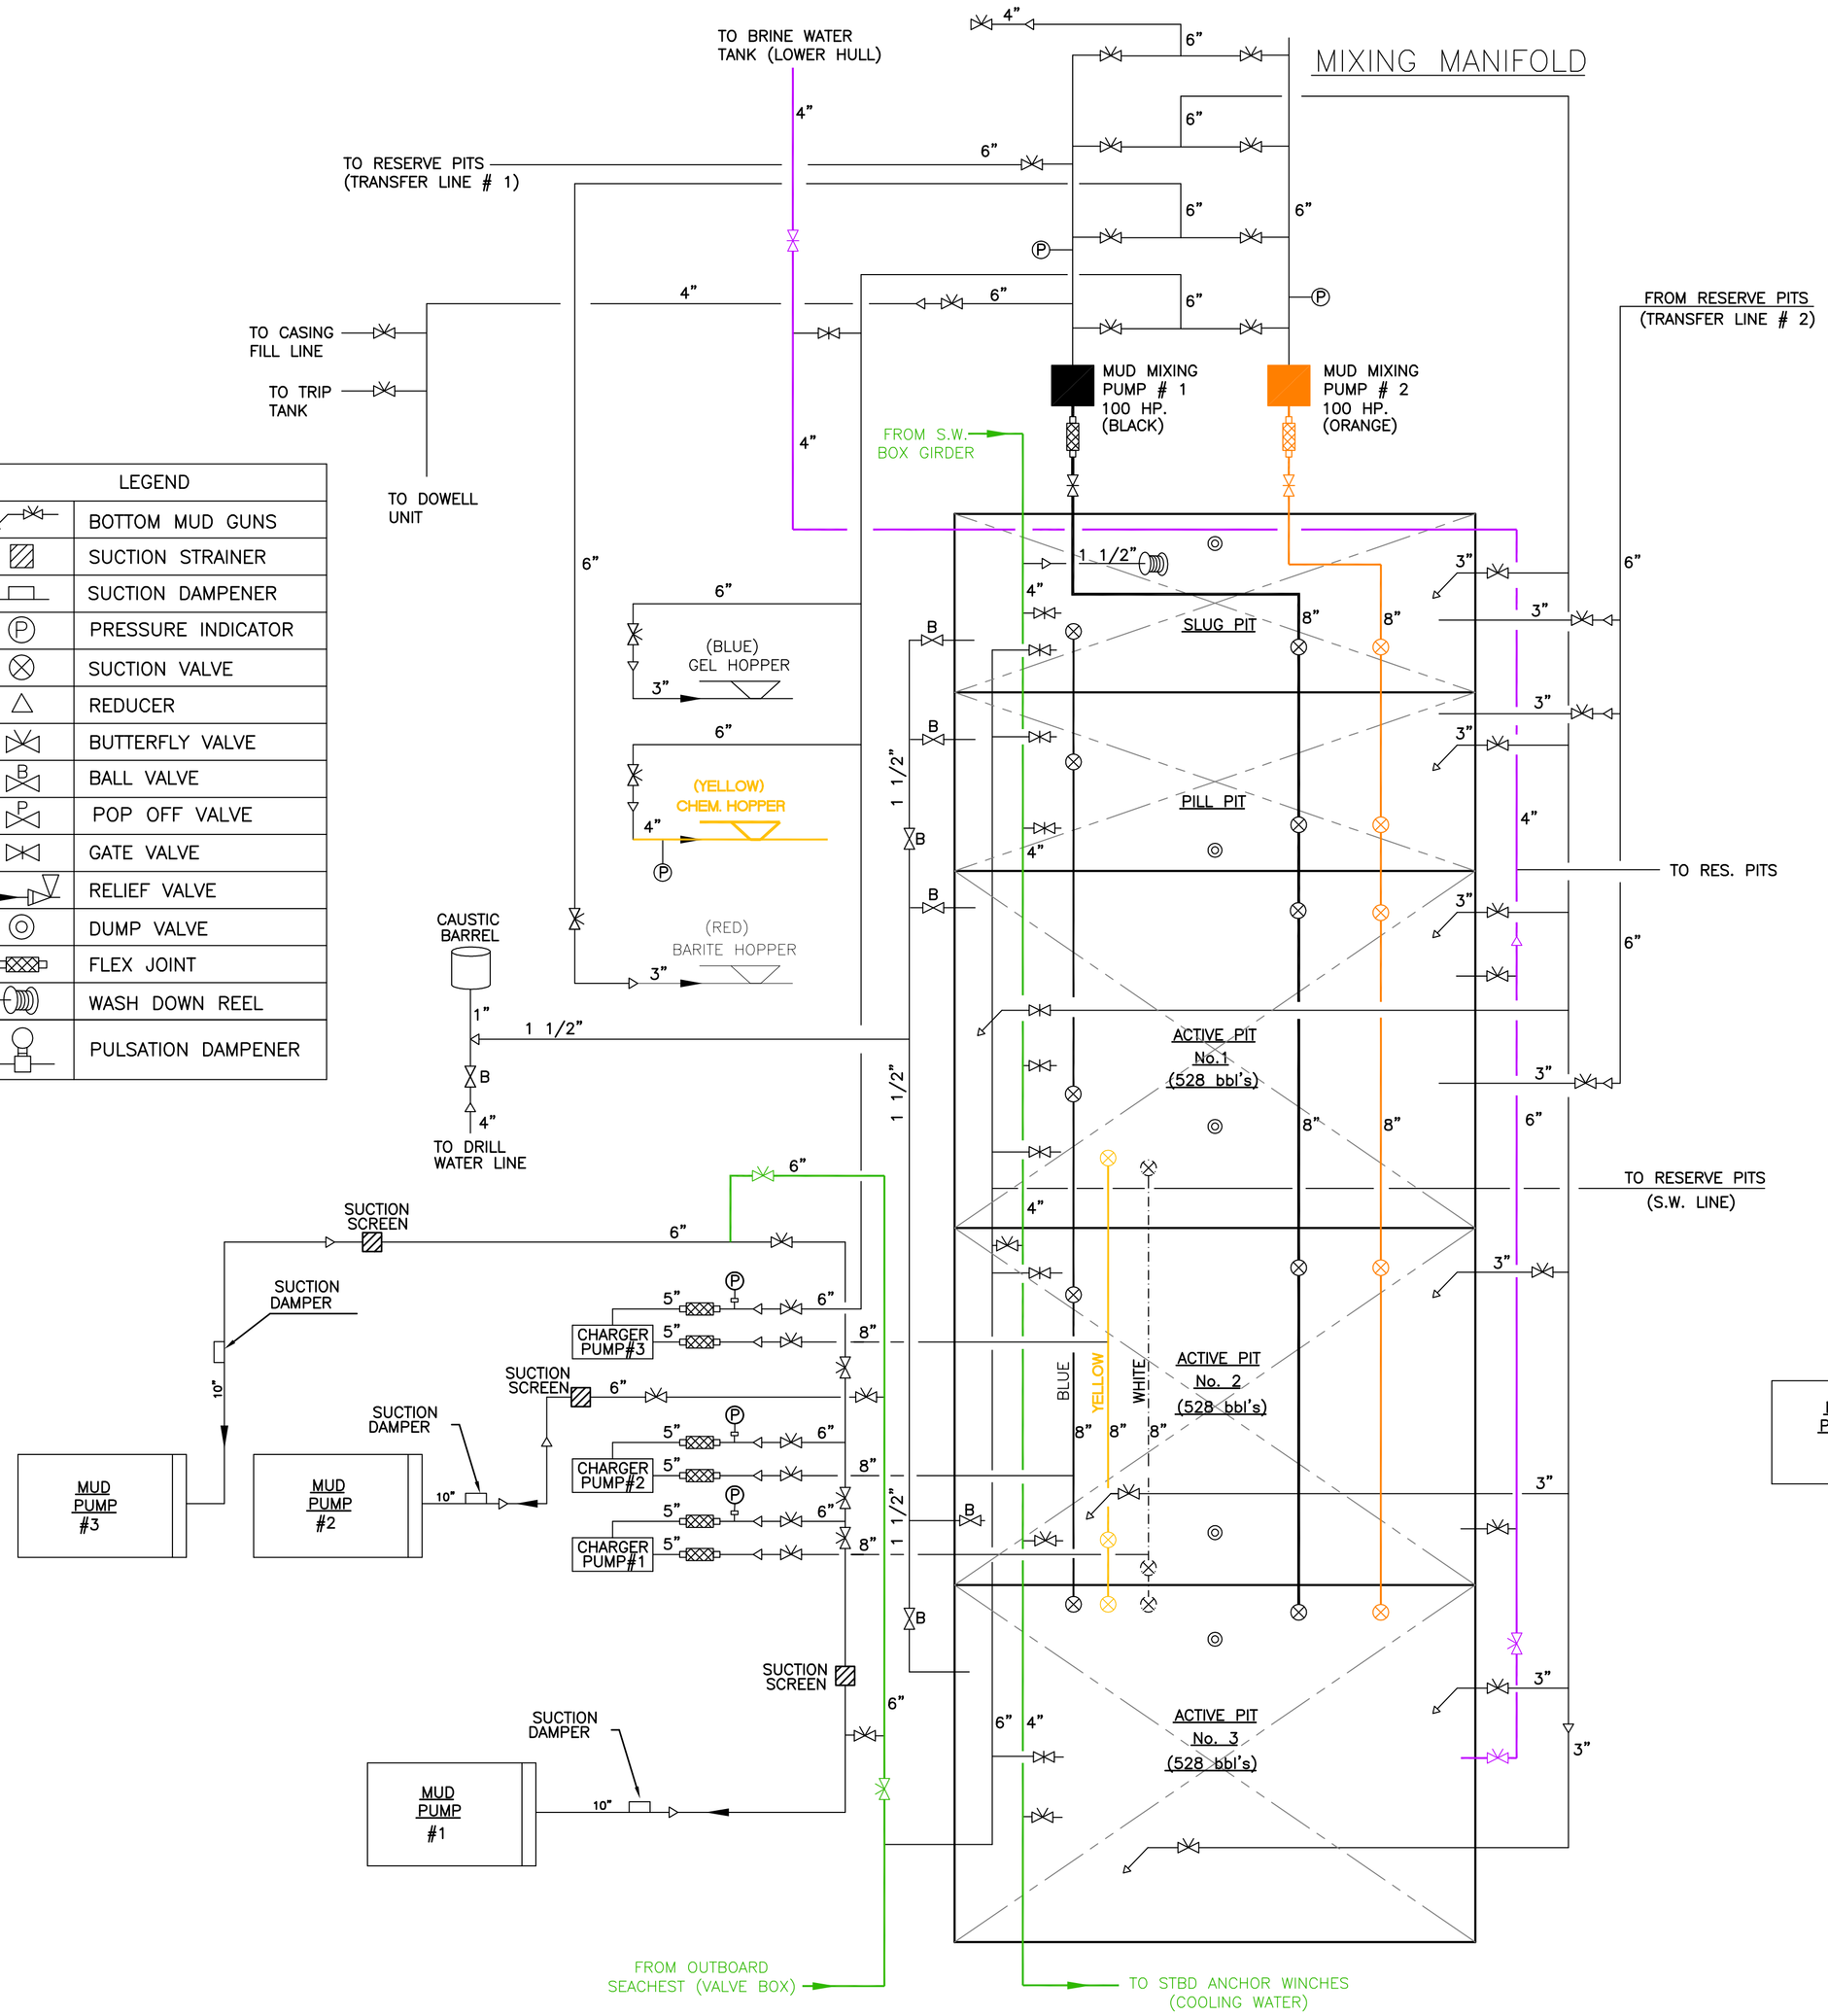

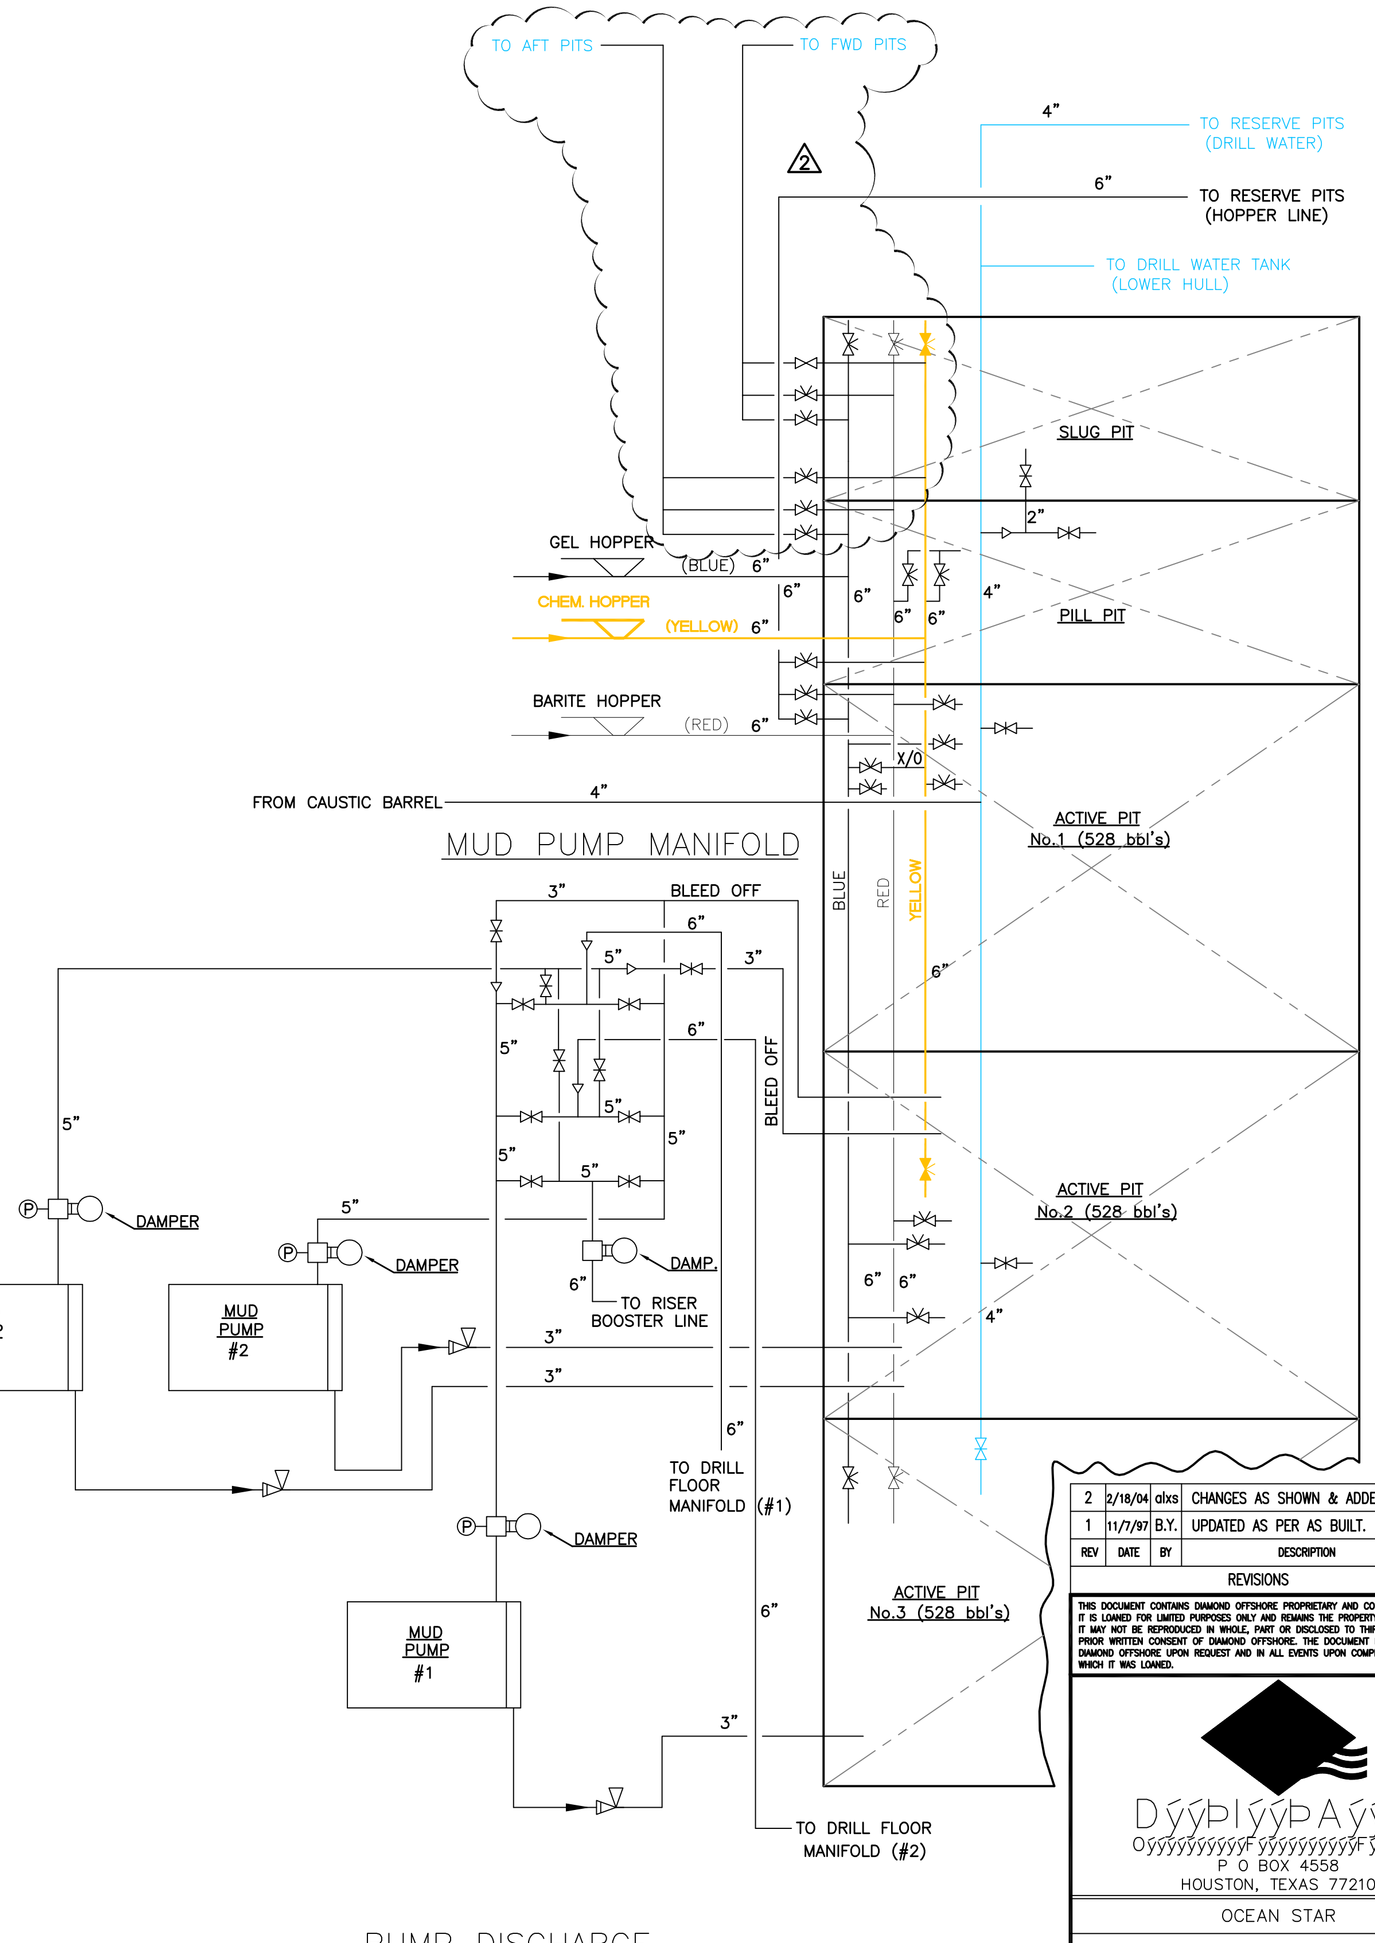

REV	DATE	BY	DESCRIPTION
2	2/18/04	alxs	CHANGES AS SHOWN & ADDED SHEET 3
1	11/7/97	B.Y.	UPDATED AS PER AS BUILT.

REVISIONS

THIS DOCUMENT CONTAINS DIAMOND OFFSHORE PROPRIETARY AND CONFIDENTIAL INFORMATION. IT IS LOANED FOR LIMITED PURPOSES ONLY AND REMAINS THE PROPERTY OF DIAMOND OFFSHORE. IT MAY NOT BE REPRODUCED IN WHOLE, PART OR DISCLOSED TO THIRD PARTIES WITHOUT THE PRIOR WRITTEN CONSENT OF DIAMOND OFFSHORE. THE DOCUMENT IS TO BE RETURNED TO DIAMOND OFFSHORE UPON REQUEST AND IN ALL EVENTS UPON COMPLETION OF THE USE FOR WHICH IT WAS LOANED.

DIAMOND OFFSHORE DRILLING, INC.
P O BOX 4558
HOUSTON, TEXAS 77210

OCEAN STAR

MUD PROCESSING DIAGRAM

ENG: JK/PA	CHK'D:	DWG No.: 167-PD-021	
DRN: MEM	APRV'D:		
SCALE: NONE		ACAD NAME: 167pd021a2	REV. # 2
DATE: 12-05-96	SHT 1 OF 3		