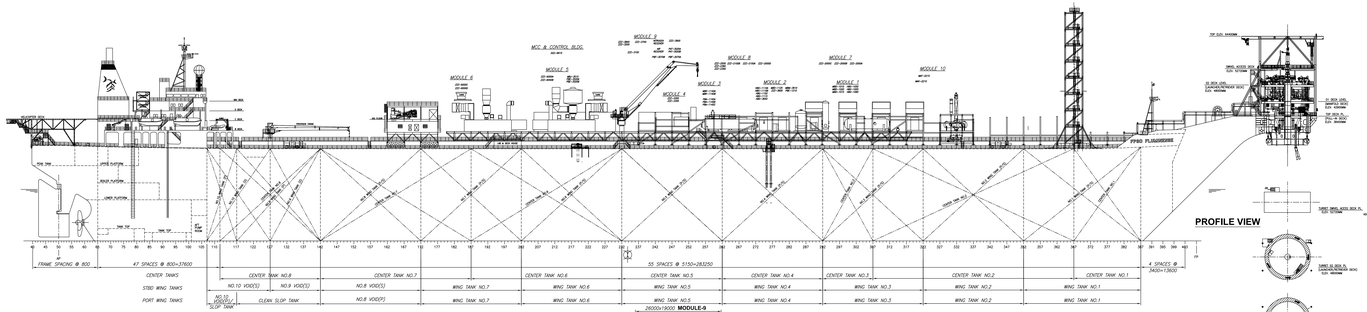

PROFILE VIEW

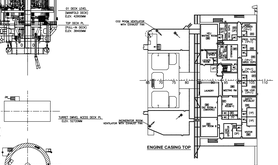

C-DECK

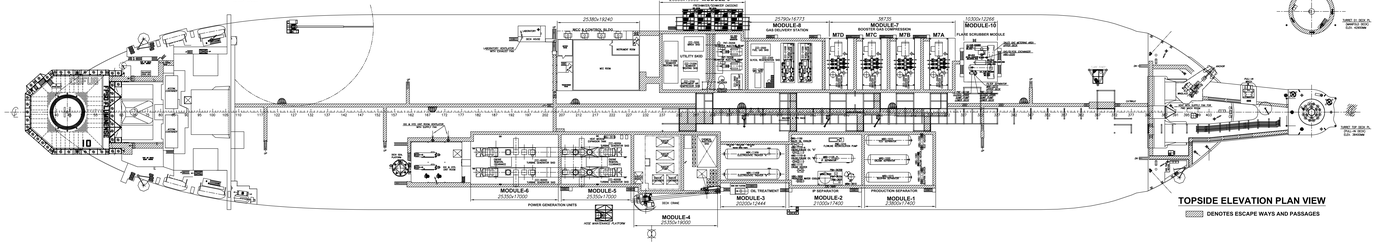

TOPSIDE ELEVATION PLAN VIEW

DENOTES ESCAPE WAYS AND PASSAGES

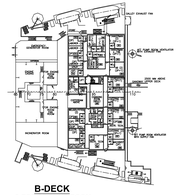

B-DECK
& TOP OF PUMP ROOM CASING

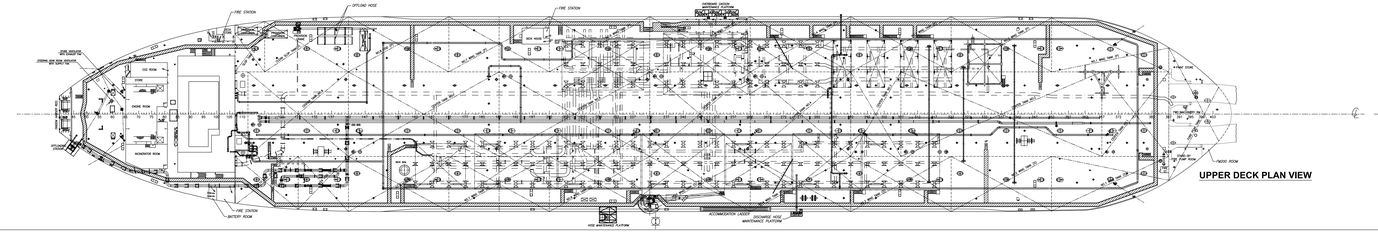

UPPER DECK PLAN VIEW

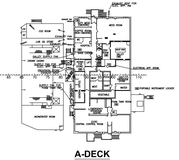

A-DECK

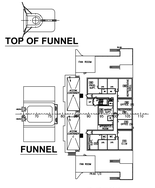

D-DECK

TOP OF STORE (PORT)
3050 MM ABOVE
PEAK TANK TOP

TOP OF NAV. HOUSE

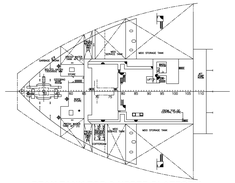

PEAK TANK TOP & UPPER PLATFORM
23175 MM ABOVE BL

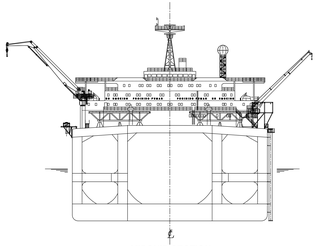

MIDSHIP SECTION
(LOOKING AFT)

NAV-DECK

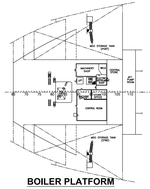

BOILER PLATFORM
18045 MM ABOVE BL

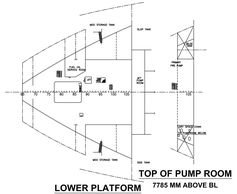

LOWER PLATFORM
12915 MM ABOVE BL

TOP OF PUMP ROOM
7785 MM ABOVE BL

PRINCIPAL PARTICULARS

LENGTH OVERALL (Loa) :	ABT. 390.0 M
LENGTH (Lbp) :	350.0 M
BREADTH (Bmld) :	60.0 M
DEPTH (Dmld) :	28.32 M
OPERAT. DRAUGHT (d.max) :	16.0 M

SCALE IN METERS

0 5M 10M 15M 20M 25M 30M 40M 50M

VENTILATION SYMBOL INDEX	
SYMBOL	DESCRIPTION
	MECHANICAL NATURAL SUPPLY
	MECHANICAL NATURAL EXHAUST

CONFIDENTIAL
PROPRIETARY INFORMATION

SHIP'S NAME: FPSO FLUMINESE

NO.	BY	REVISION DESCRIPTION	DATE	CHK'D.	APPV'D.
3	JSPL	CERTIFIED AS-BUILT	27.02.03	–	–
2	MJS	UPDATED PER CHANGES	03.13.02	PM	HH
1	MJS	UPDATED PER PROGRESS	12.20.01		
0	MJS	ISSUED FOR SHIPYARD CONTRACT	10.23.01		

MODEC INTERNATIONAL LLC CONFIDENTIALITY AGREEMENT
THIS DRAWING AND ITS CONTENTS, SPECIFICATIONS, & DESIGN CONCEPTS ARE PROPRIETARY INFORMATION AND MAY NOT BE REPRODUCED, TRANSFERRED OR ISSUED FOR USE WITHOUT WRITTEN CONSENT FROM MODEC INTERNATIONAL LLC

CLIENT: ENTERPRISE OIL

Bijupira & Salema

DRAWN BY: JSPL
DWG DATE: 27-02-2003
DWG SCALE: 1:300 / N/ D+ SIZE
SHEET: 1 OF 1

MODEC INTERNATIONAL LLC

PROJECT: BIJUPIRA & SALEMA FIELD DEVELOPMENT
(Enterprise Project Number – 101.18.10)
(MODEC Project Number – 1058)

TITLE: FPSO GENERAL ARRANGEMENT

CAD FILE: 1058-MI-20-00-01-0001-2
DWG. NO: 1058-MI-20-00-01-0001
REV. NO: 3